

EXISTING LEGEND:

- |     |                              |   |                            |
|-----|------------------------------|---|----------------------------|
| □   | MAIL BOX                     | ☼ | STREET LIGHT/FLOOD LIGHT   |
| ●   | POWER POLE                   | ☼ | PARKING LIGHT/W CONC. BASE |
| ○   | POWER POLE W/LT.<br>DOWN GUY | ○ | SIGNAL POLE                |
| ○   | UTILITY MARK                 | ● | SIGN                       |
| ○   | MANHOLE                      | ● | WATER VALVE                |
| ○   | SBC MANHOLE                  | ■ | WATER METER                |
| ○   | ELEC BOX                     | ● | FIRE HYDRANT               |
| □   | LIGHT STANDARD               | ○ | GAS METER                  |
| □   | GRATE INLET                  | ○ | GAS VALVE                  |
| □   | B OR BB INLET                | ○ | SPRINKLER VALVE            |
| □   | C INLET                      | ○ | BUSH                       |
| □   | E INLET                      | ○ | CLEANOUT                   |
| □   | GATE                         | ○ | COLUMN                     |
| □   | PLANTER                      | ○ | REFERENCE INFORMATION      |
| ○   | TREE                         | ○ | TREE-PINE                  |
| /// | ASPHALT SYMBOL               | ○ | METAL BOLLARD              |
| ○   | CONC. COLUMN                 | □ | METRO TEST BOX             |
| ○   | SPRINKLER HEAD               | □ | IRRIGATION CONTROL VALVE   |
| ▲   | SURVEY CONTROL POINT         | ● | TRASH CAN                  |

PROPOSED LEGEND:

- |   |                      |
|---|----------------------|
| — | WATER LINE           |
| — | STORM LINE           |
| — | SANITARY SEWER LINE  |
| — | 7" CONCRETE PAVEMENT |
| — | 6" CONCRETE PAVEMENT |


NOTES:

- CONTRACTOR SHALL CONSTRUCT ALL SIDEWALKS AND RAMPS IN COMPLIANCE WITH A.D.A. AND T.D.L.R. REQUIREMENTS.
- SIDEWALK CROSS SLOPE AND CROSS SLOPE IN THE HANDICAP AREA SHALL NOT EXCEED 2%.
- ACCESSIBLE SIDEWALKS LONGITUDINAL SLOPE SHALL NOT EXCEED SLOPE OF 1:20.
- PROVIDE EXPANSION JOINTS AT MAXIMUM 40' C-C AND CONTROL JOINTS @ EVERY 4' C-C FOR THE SIDEWALK UNLESS MENTIONED OTHERWISE.
- RAMPS LONGITUDINAL SLOPE SHOULD NOT EXCEED 1:15 (V:H). RAMP'S RISE SHOULD NOT EXCEED 6" AND HORIZONTAL PROJECTION SHOULD NOT EXCEED 72" WITHOUT HANDRAIL.
- PROVIDE EXPANSION JOINTS AT MAXIMUM 80' C-C AND CONSTRUCTION JOINTS AT MAXIMUM 20' C-C FOR THE PARKING LOT UNLESS MENTIONED OTHERWISE.

Pierce Goodwin Alexander & Liville

THIS RECORD DRAWING HAS BEEN PREPARED BY PART BASED UPON INFORMATION FURNISHED BY OTHERS. THE ARCHITECT ASSUMES NO RESPONSIBILITY FOR THE ACCURACY OF THIS RECORD DRAWING OR FOR ANY INFORMATION PROVIDED TO THE ARCHITECT. THOSE RELYING ON THIS RECORD DOCUMENT ARE ADVISED TO OBTAIN INDEPENDENT VERIFICATION OF ITS CONTENTS.

REGISTRATION  
COPYRIGHT ©

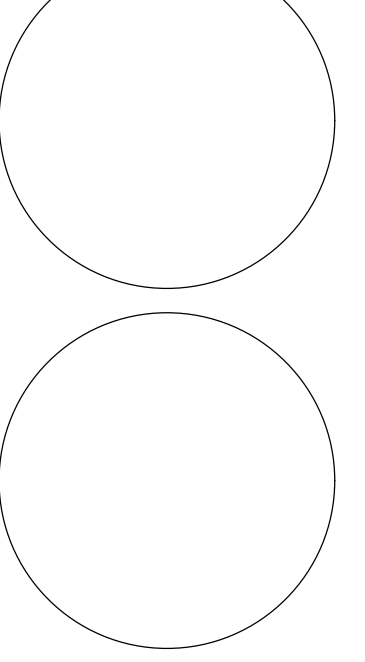

SHEET TITLE

OVERALL SITE PLAN

SHEET NUMBER

**C1.00**

DATE: 08/29/2016  
 DRAWN BY: KIMBERLY GONZALES  
 CHECKED BY: KIMBERLY GONZALES  
 PROJECT: HCC NORTH FOREST CAMPUS WORKFORCE RENOVATION, NEW ACADEMIC BUILDING, AND CENTRAL PLANT